


110-G

BOUNDARY LINE 7

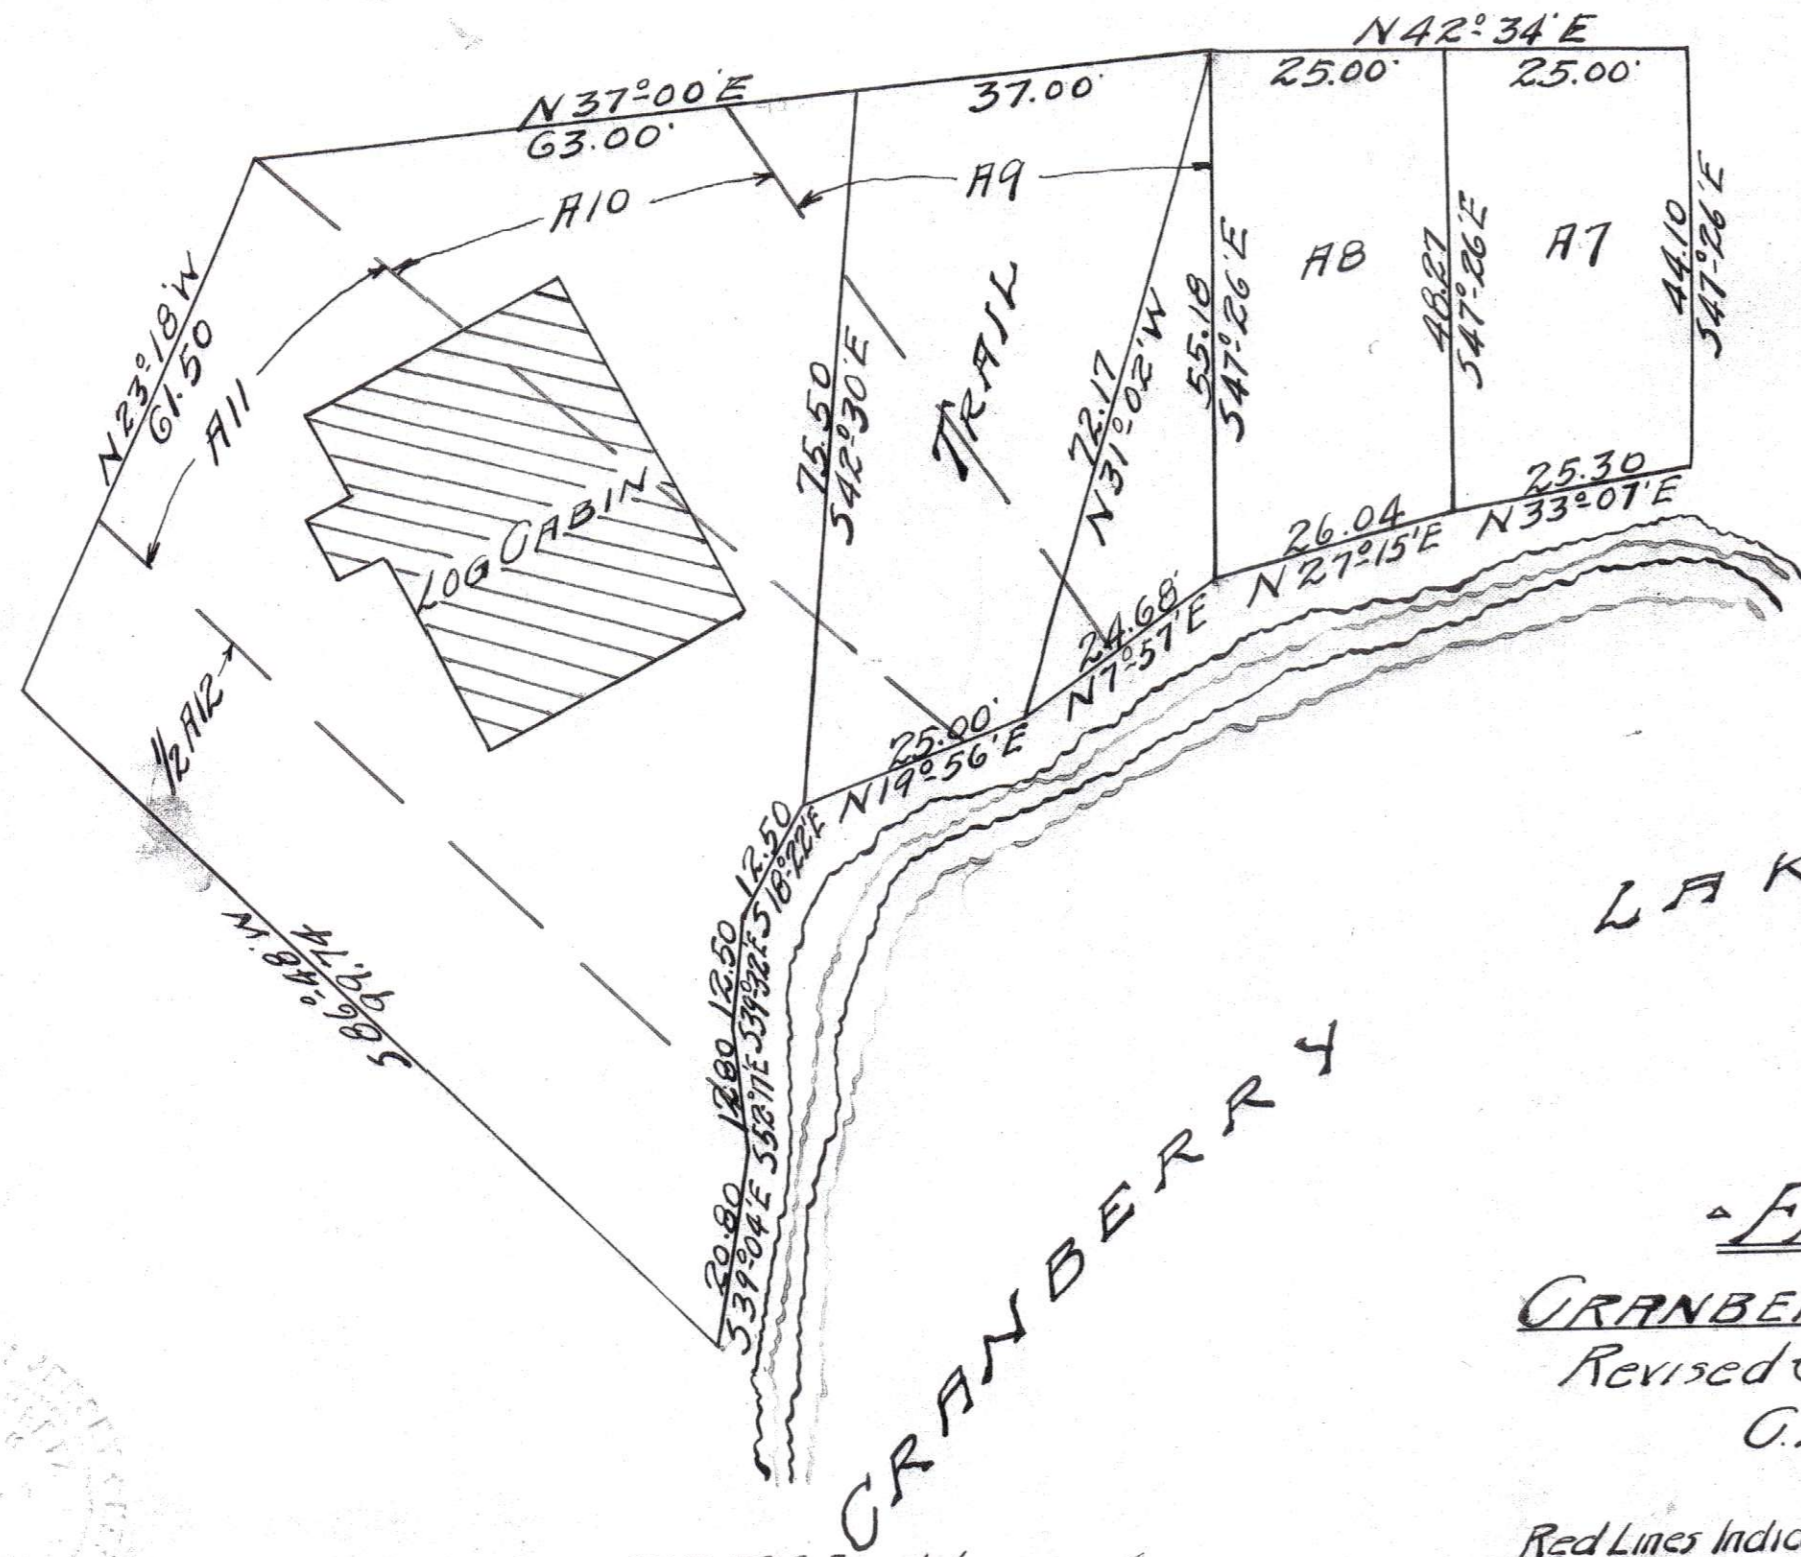

FRENCH'S GROVE
CRANBERRY LAKE SUMMER COLONY
 Revised Survey for Log Cabin Site & Trail

G. A. EVERTZ, ENGINEER
 October 22, 1926
 Red Lines Indicate Survey Made April 24, 1923 By GURKE MILLEN, Map No. 1
 Scale 1" = 20'

Approved in accordance with Chapter 22A, P.L. 1921, as Amended
 Carl A. Evertz
 ENGINEER & SURVEYOR LICENSE No. 1444

110-G